


KEY PLAN
NOT TO SCALE

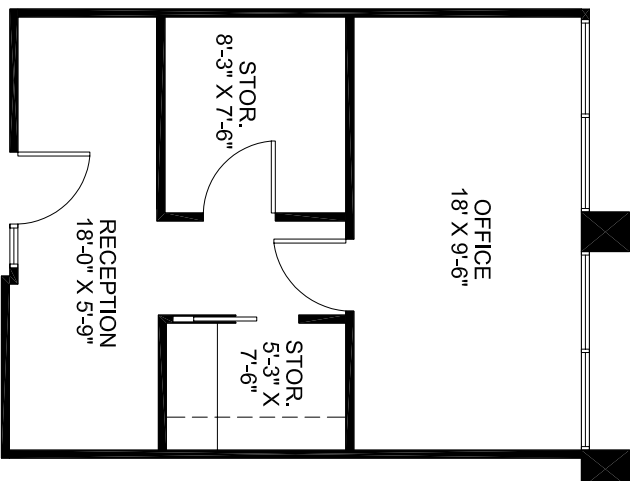

AS-BUILT PLAN
SUITE 235 504 RSF

CONCOURSE OFFICE PARK

6330 LBJ FREEWAY DALLAS, TEXAS



iDGROUP

09-01-05



TRANSWESTERN
COMMERCIAL SERVICES